


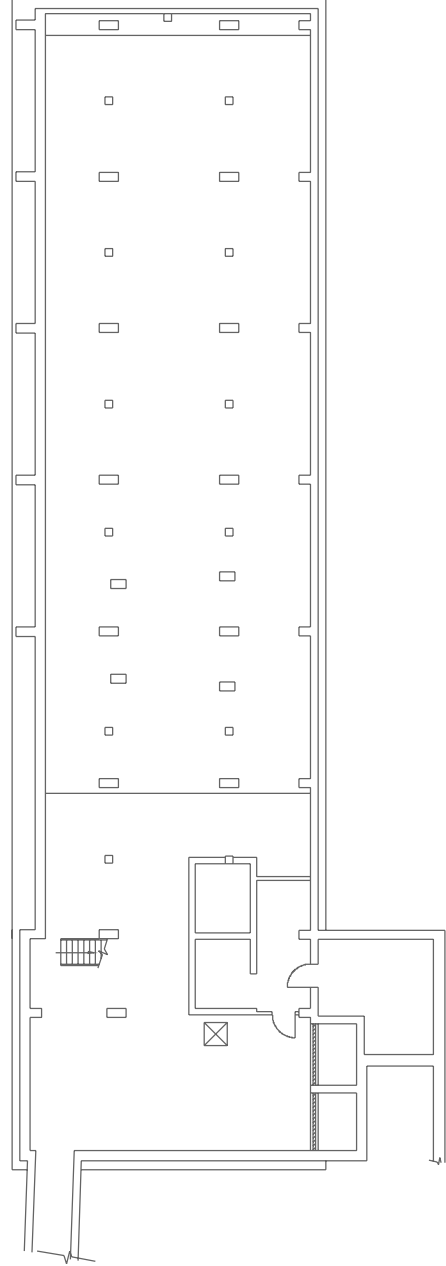
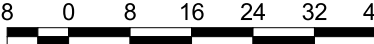



SAPHYRE Spatial Database

Sub Basement Floor
Quincy House



8 0 8 16 24 32 40 Feet






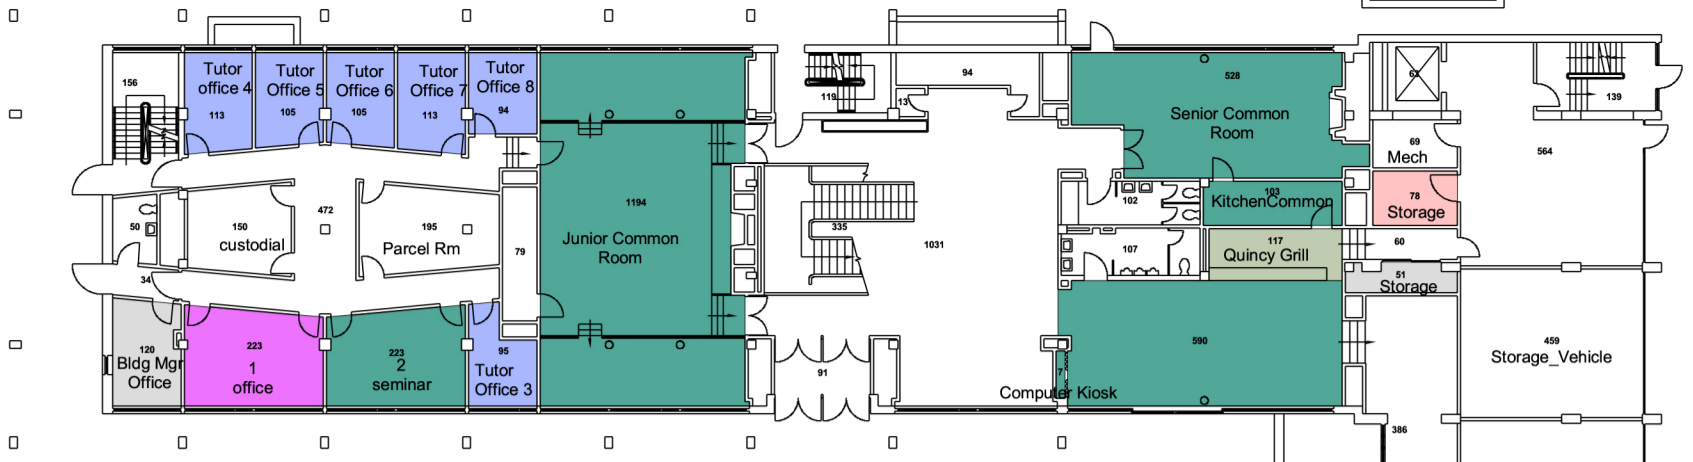




SAPHYRE Spatial Database

First Floor Quincy House

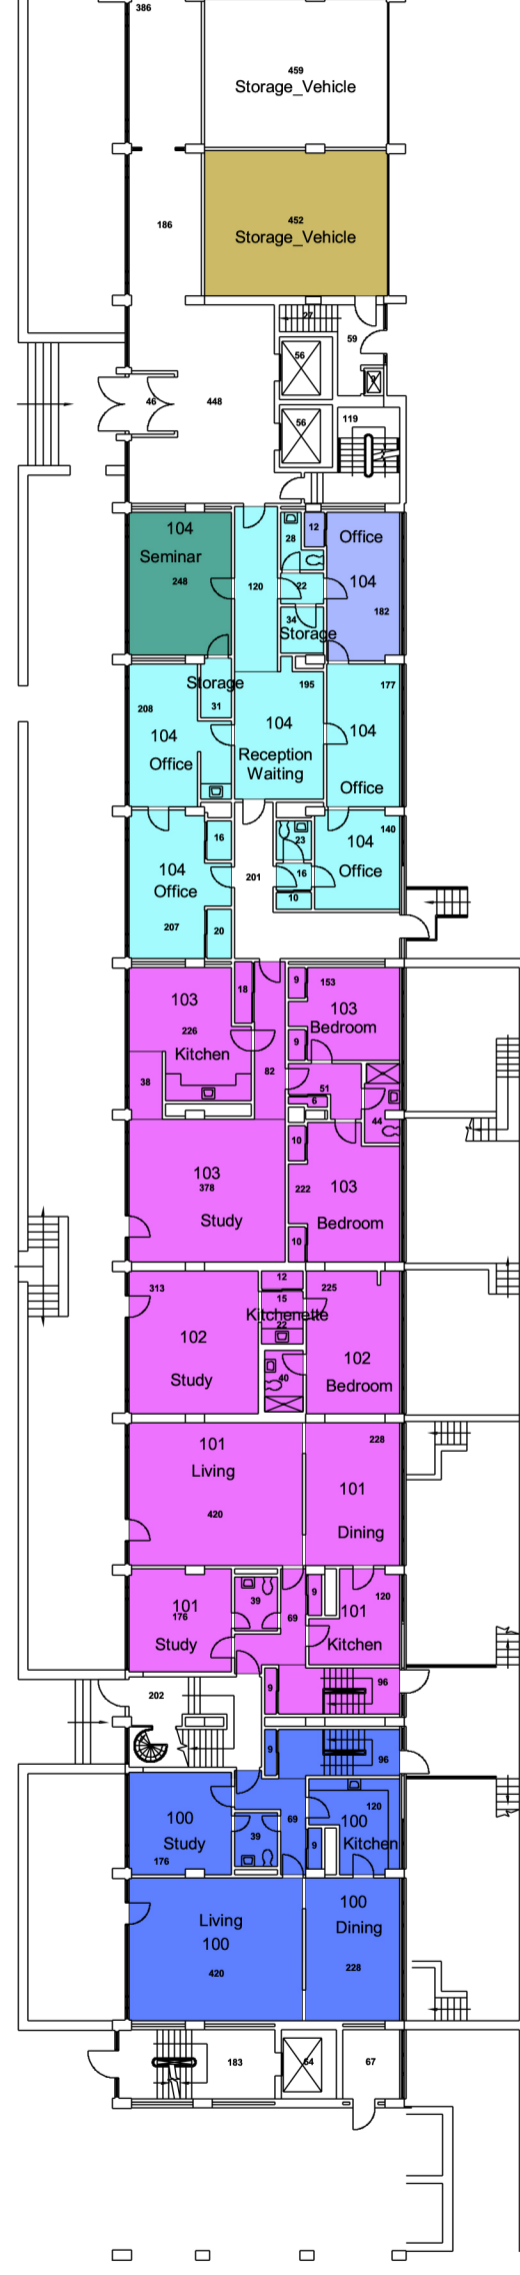Users	
HUDS	shared staff
PhysRes	student
masters	student group
renter	tutor
res dean	

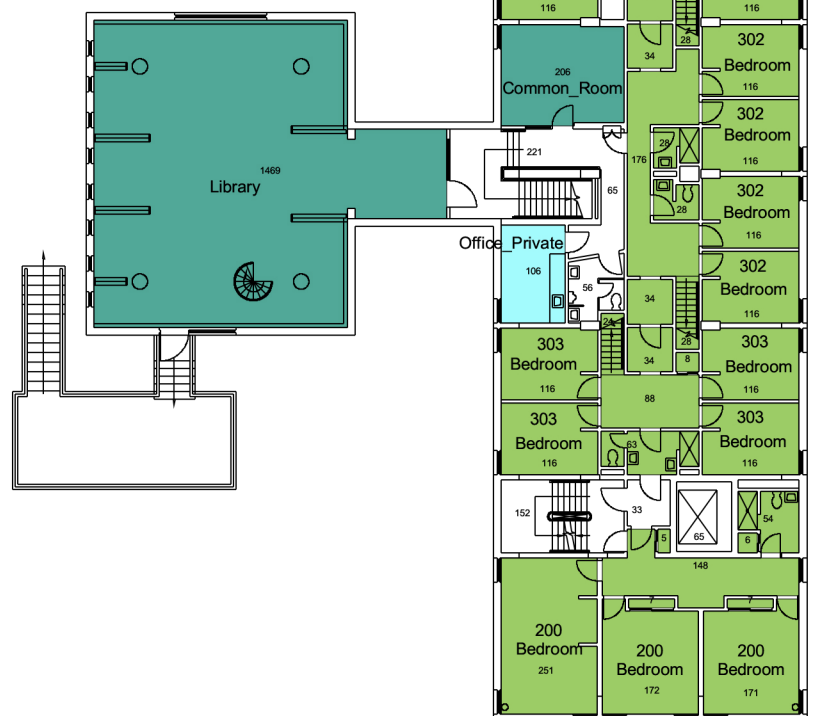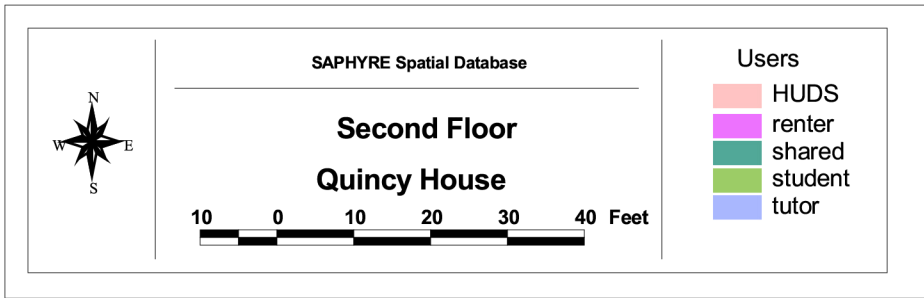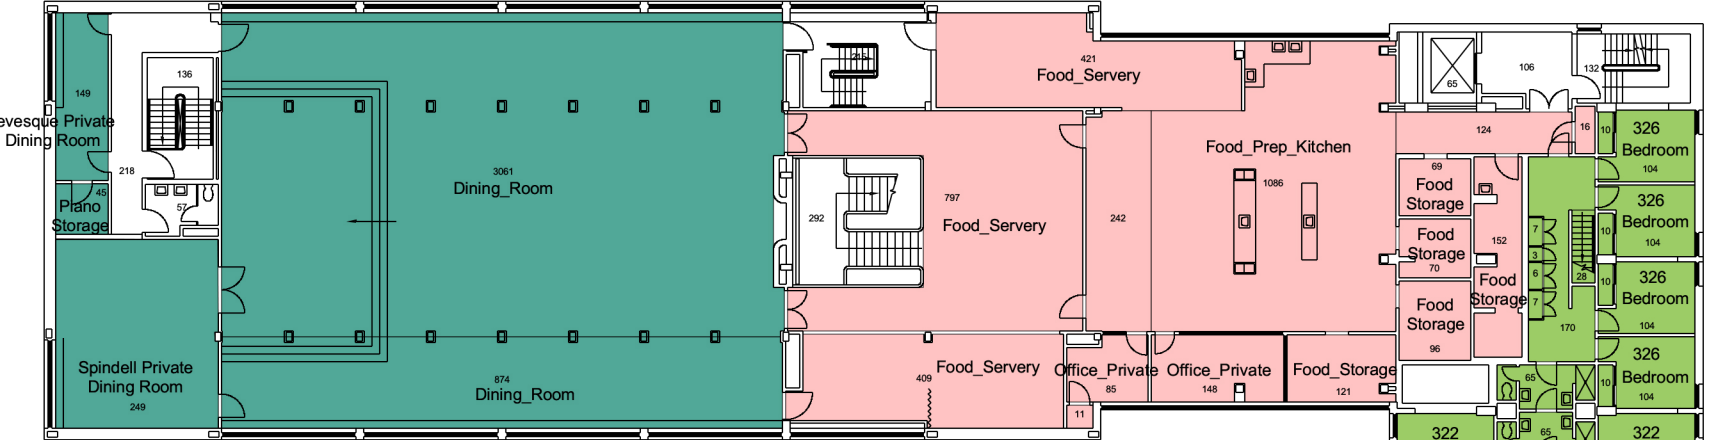







 Program:
 Tutor
 Program:
 Student

Quincy House
 58 Plympton Street Cambridge MA 02138
Third
 As Built
 Dec 10, 2014



CenterStone

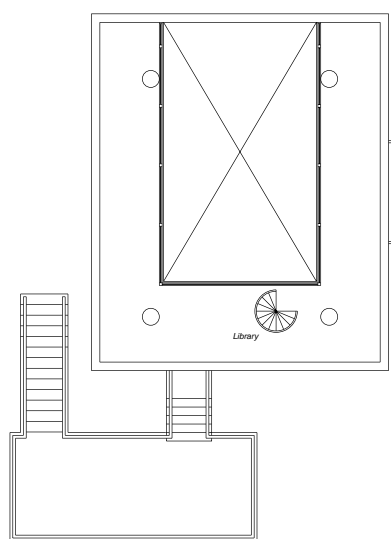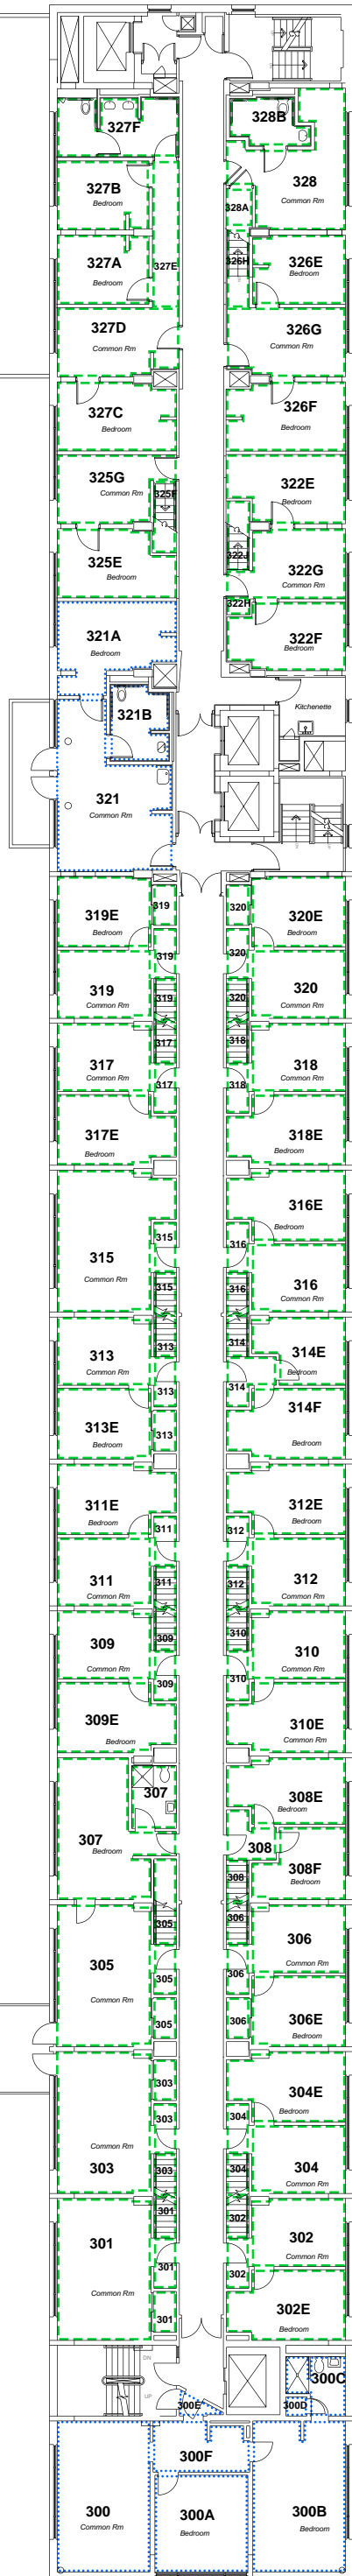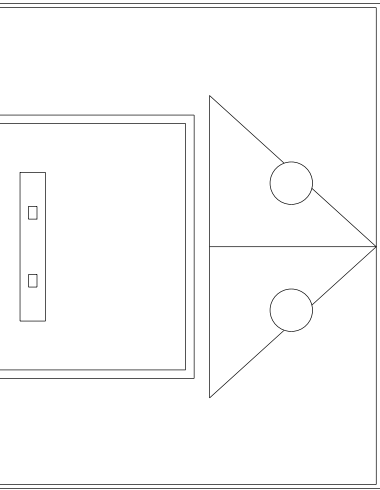

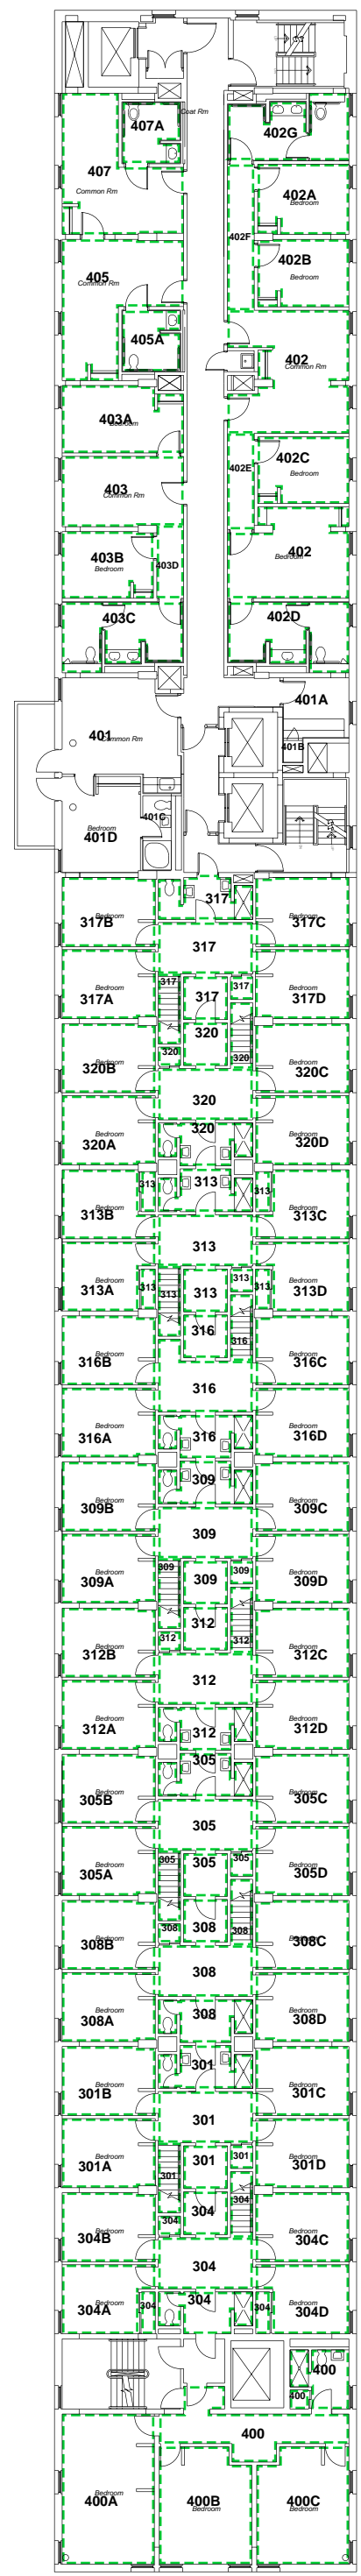





TOTALS

 Program:
 Student

Quincy House
 56 Plympton Street Cambridge MA 02138
Fourth
 As Built
 Dec 12, 2014





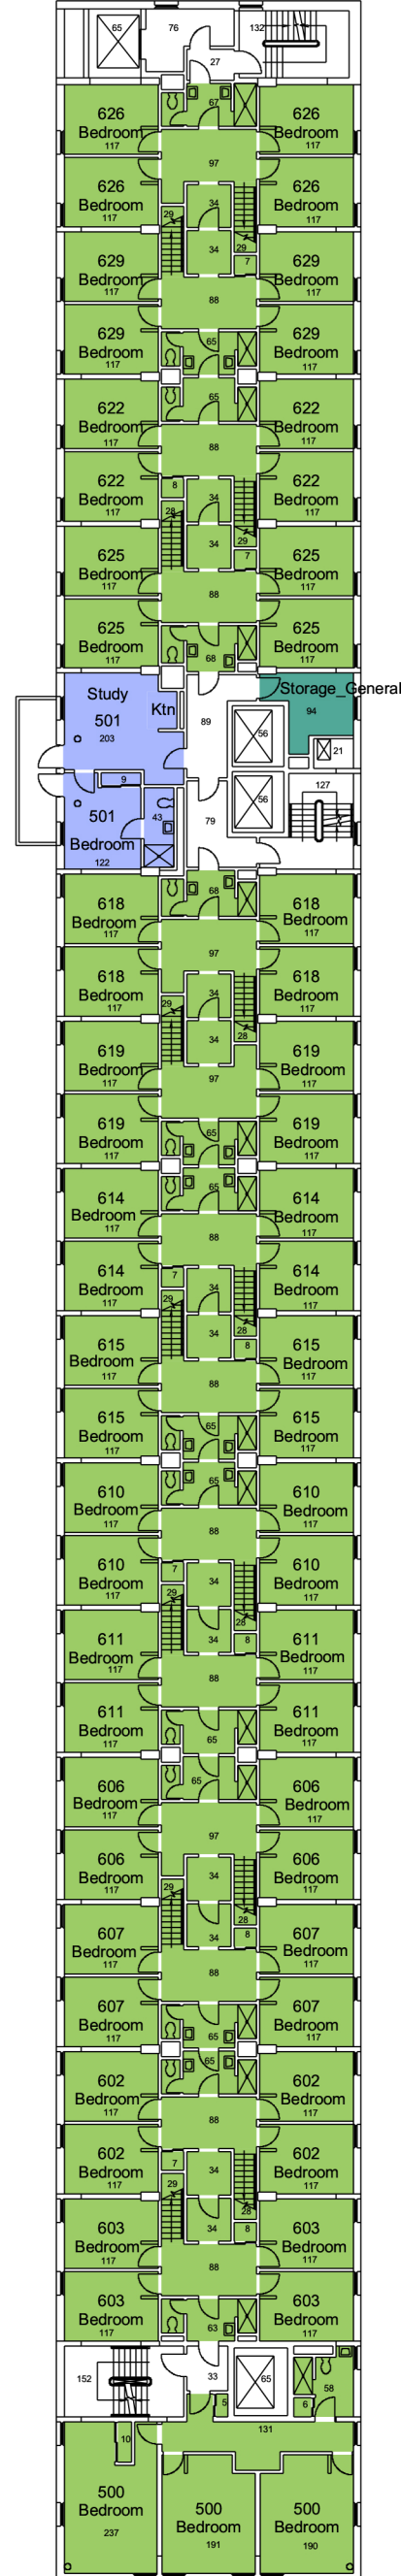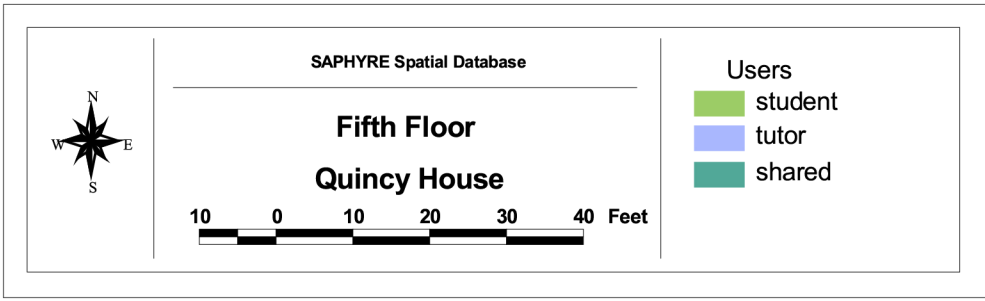

Sixth Floor Quincy House




Users

- student
- tutor
- shared




Seventh Floor

Quincy House

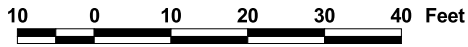

- Users
- masters aides
 - student
 - tutor

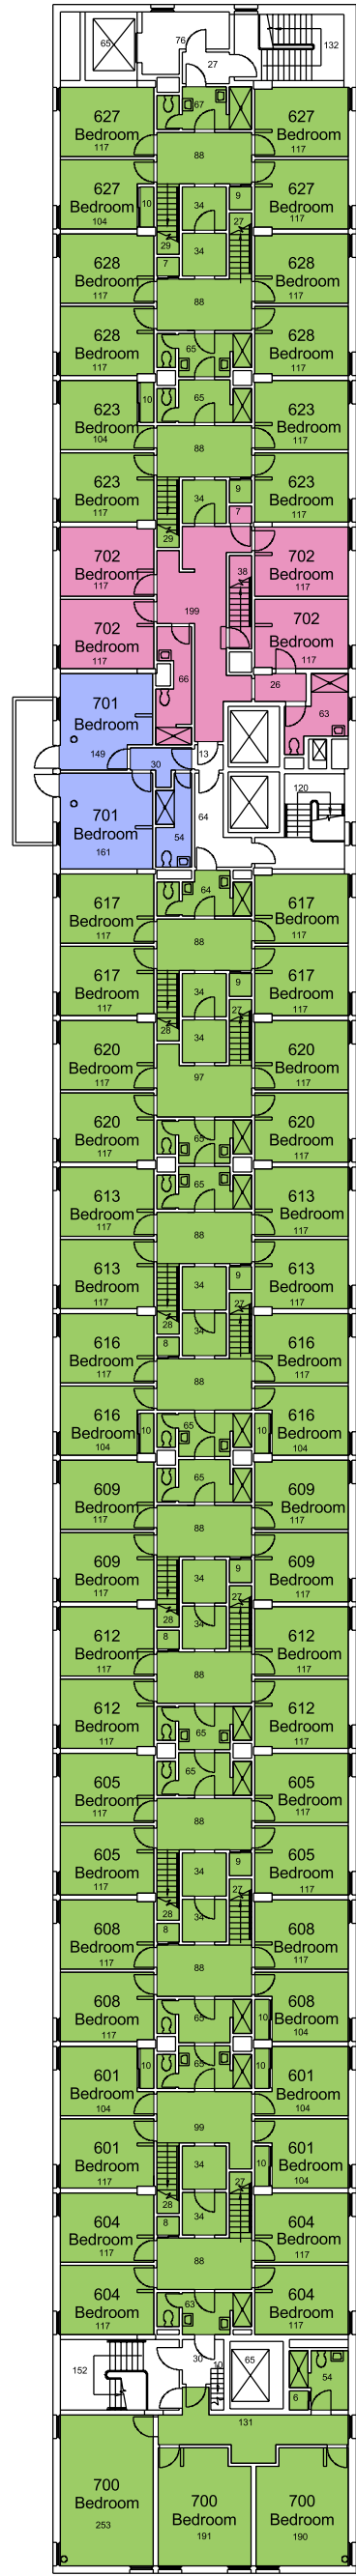

Eighth Floor


Quincy House

10 0 10 20 30 40 50 Feet




Users

masters

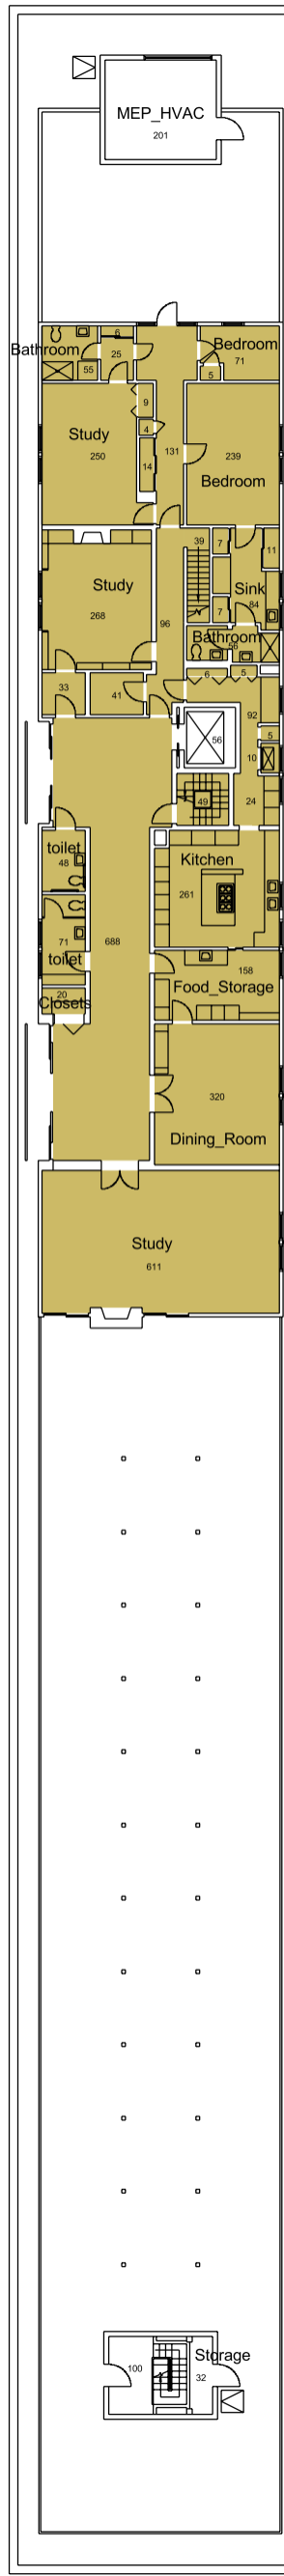




Ninth Floor
Quincy House

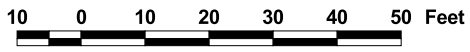

Users

 masters

