


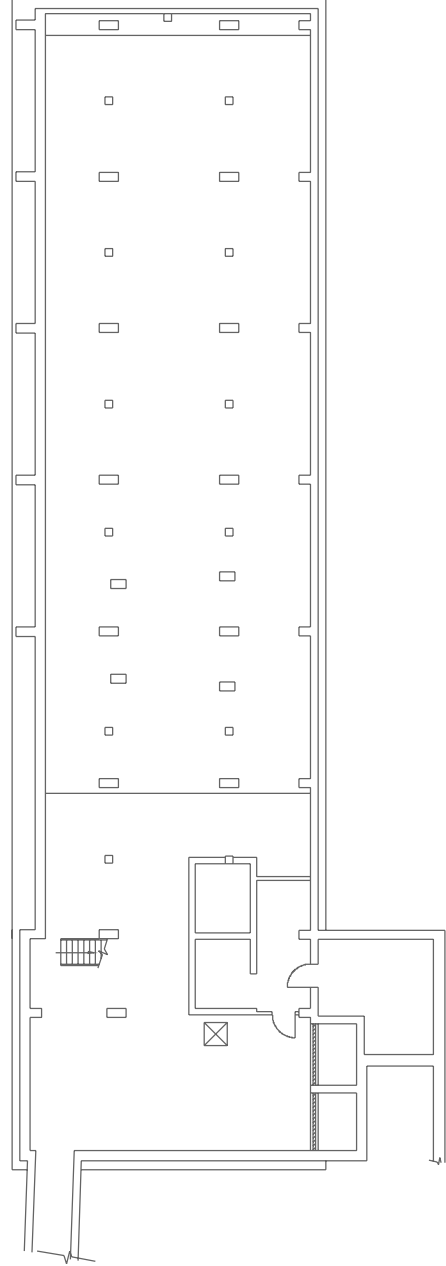
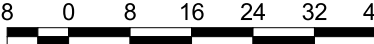









SAPHYRE Spatial Database

Sub Basement Floor  
Quincy House



8 0 8 16 24 32 40 Feet



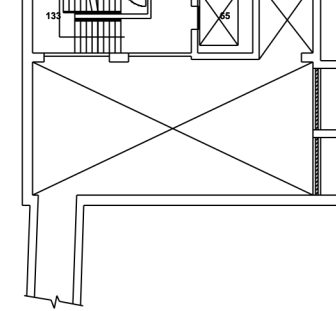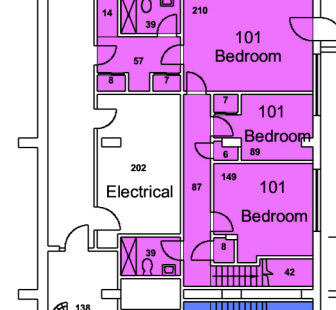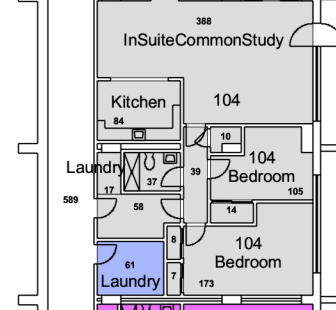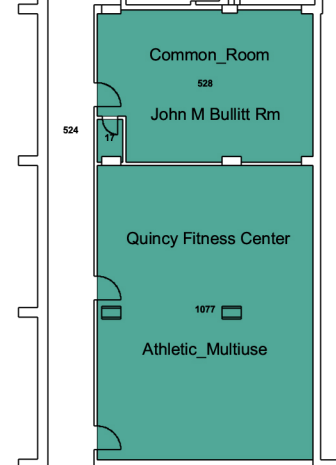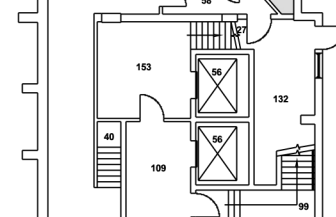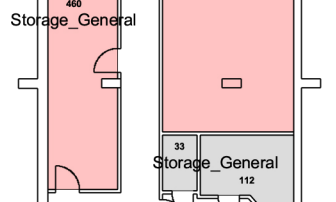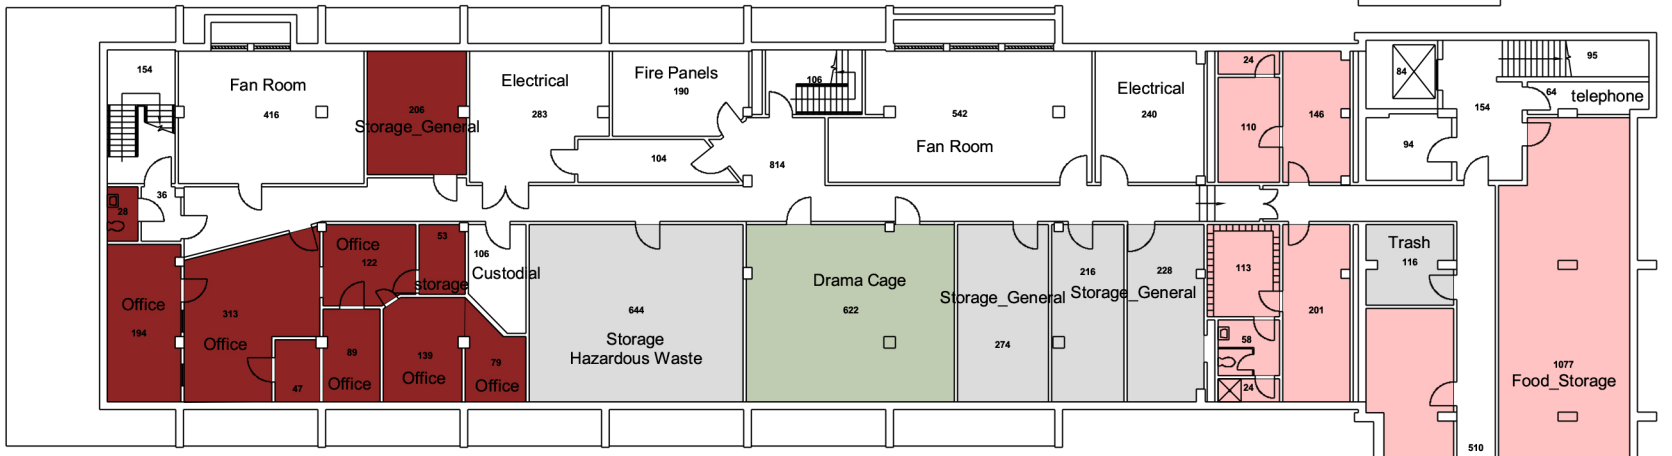


SAPHYRE Spatial Database  
 Quincy House Basement

10 0 10 20 30 40 50 Feet

**Users**


<span style="display:inline-block; width:15px; height:15px; background-color:darkred;"></span> FMO	<span style="display:inline-block; width:15px; height:15px; background-color:magenta;"></span> renter
<span style="display:inline-block; width:15px; height:15px; background-color:lightcoral;"></span> HUDS	<span style="display:inline-block; width:15px; height:15px; background-color:teal;"></span> shared
<span style="display:inline-block; width:15px; height:15px; background-color:lightgrey;"></span> PhysRes	<span style="display:inline-block; width:15px; height:15px; background-color:lightgreen;"></span> student group
<span style="display:inline-block; width:15px; height:15px; background-color:blue;"></span> Res Dean	<span style="display:inline-block; width:15px; height:15px; background-color:lightblue;"></span> tutor
<span style="display:inline-block; width:15px; height:15px; background-color:gold;"></span> masters	



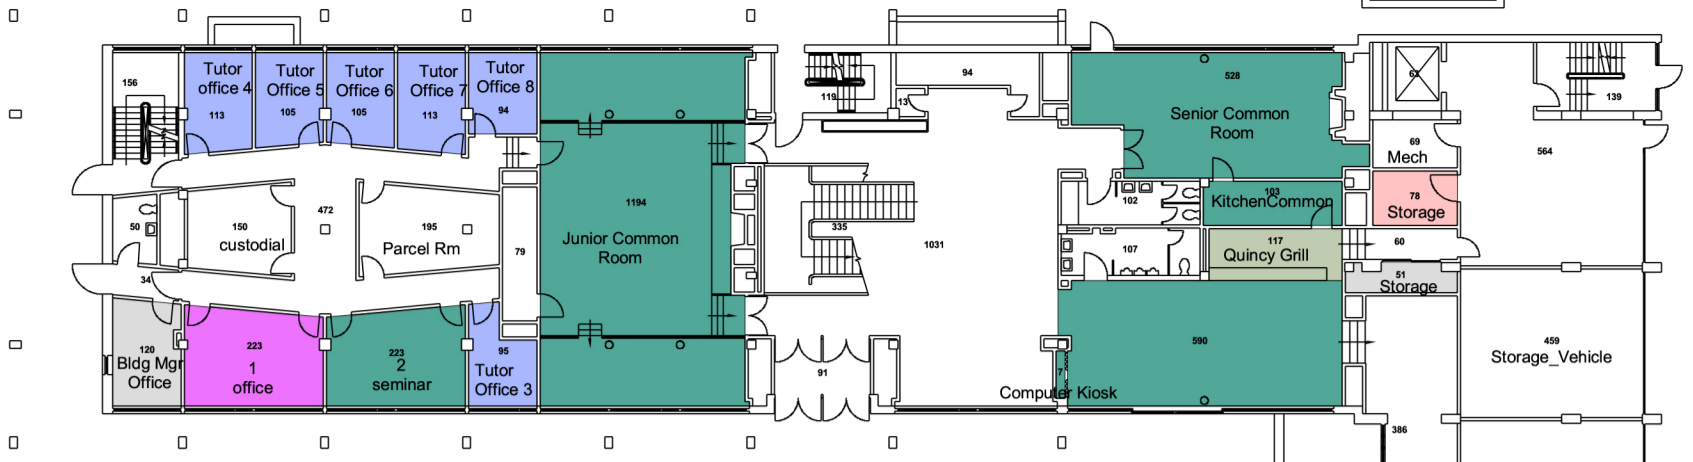




SAPHYRE Spatial Database

**First Floor**  
**Quincy House**

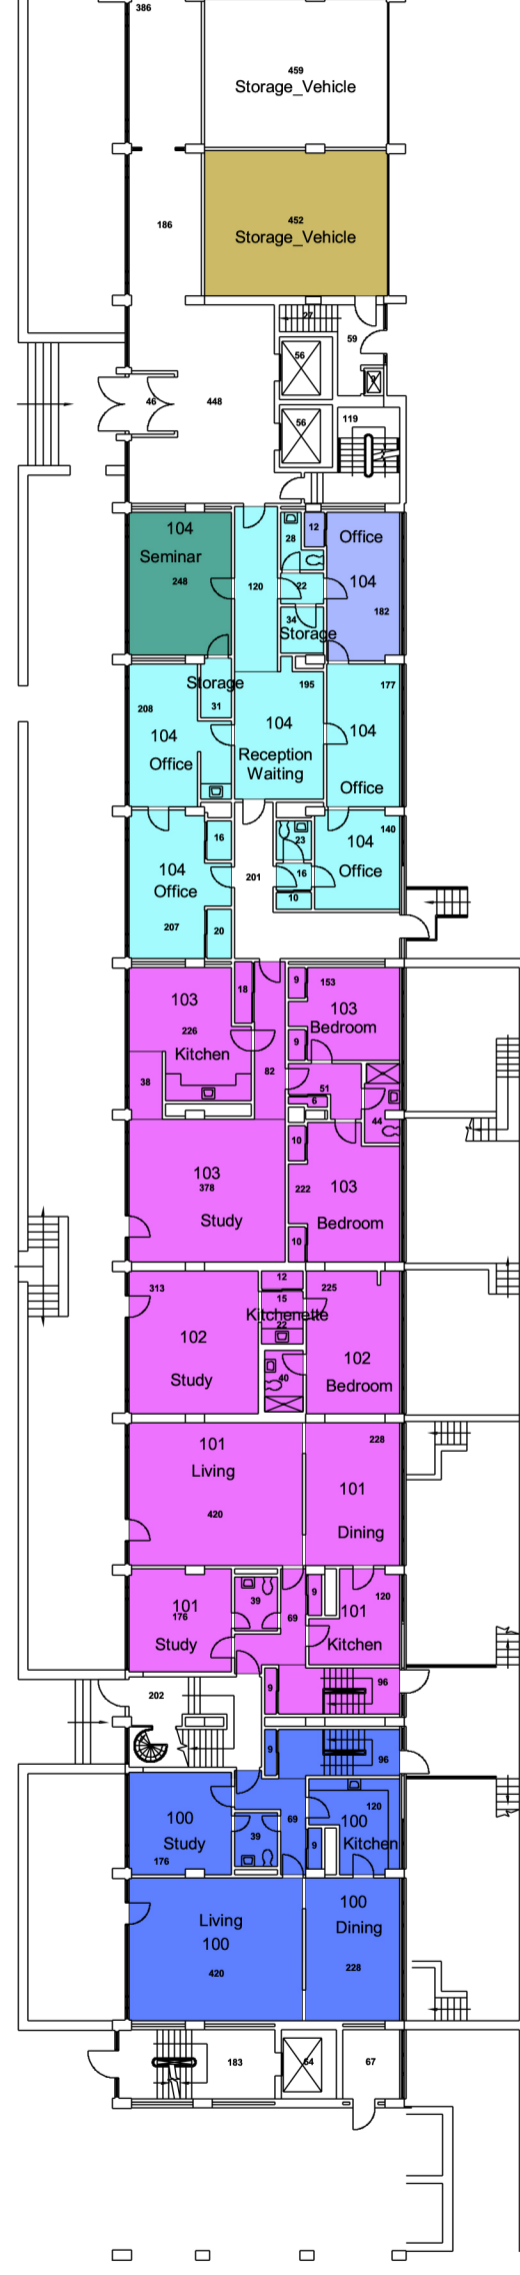Users	
HUDS	shared staff
PhysRes	student
masters	student group
renter	tutor
res dean	

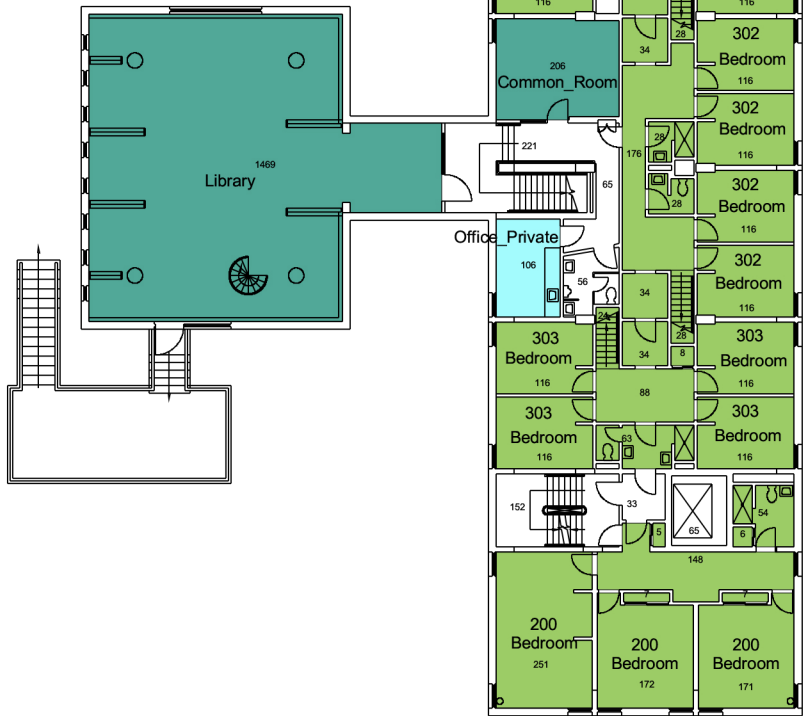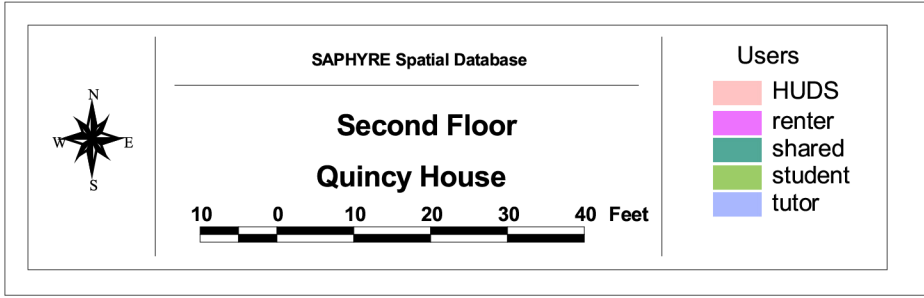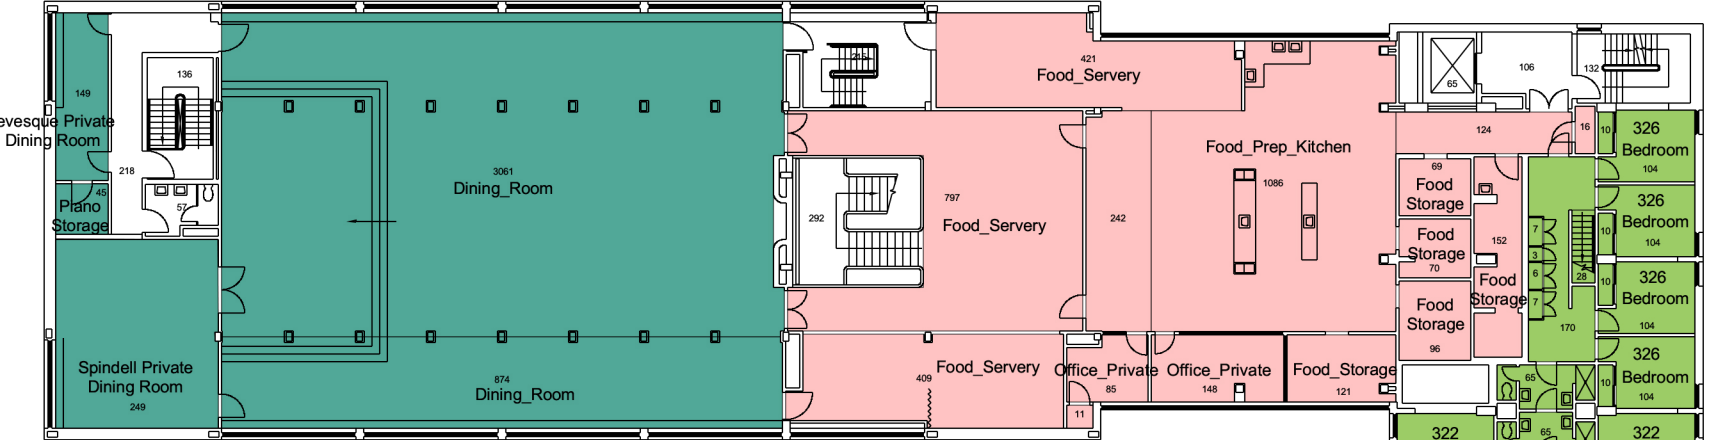







 Program:  
 Tutor  
 Program:  
 Student



**Quincy House**  
 58 Plympton Street Cambridge MA 02138  
**Third**  
 As Built  
 Dec 10, 2014



CenterStone

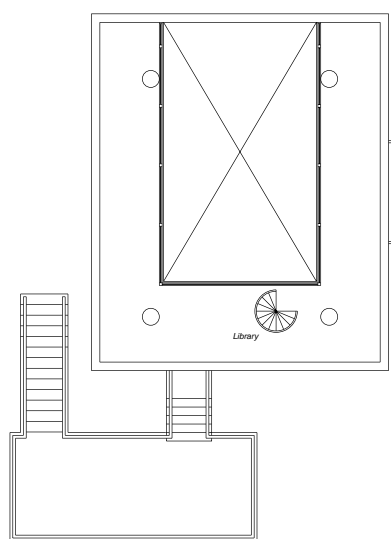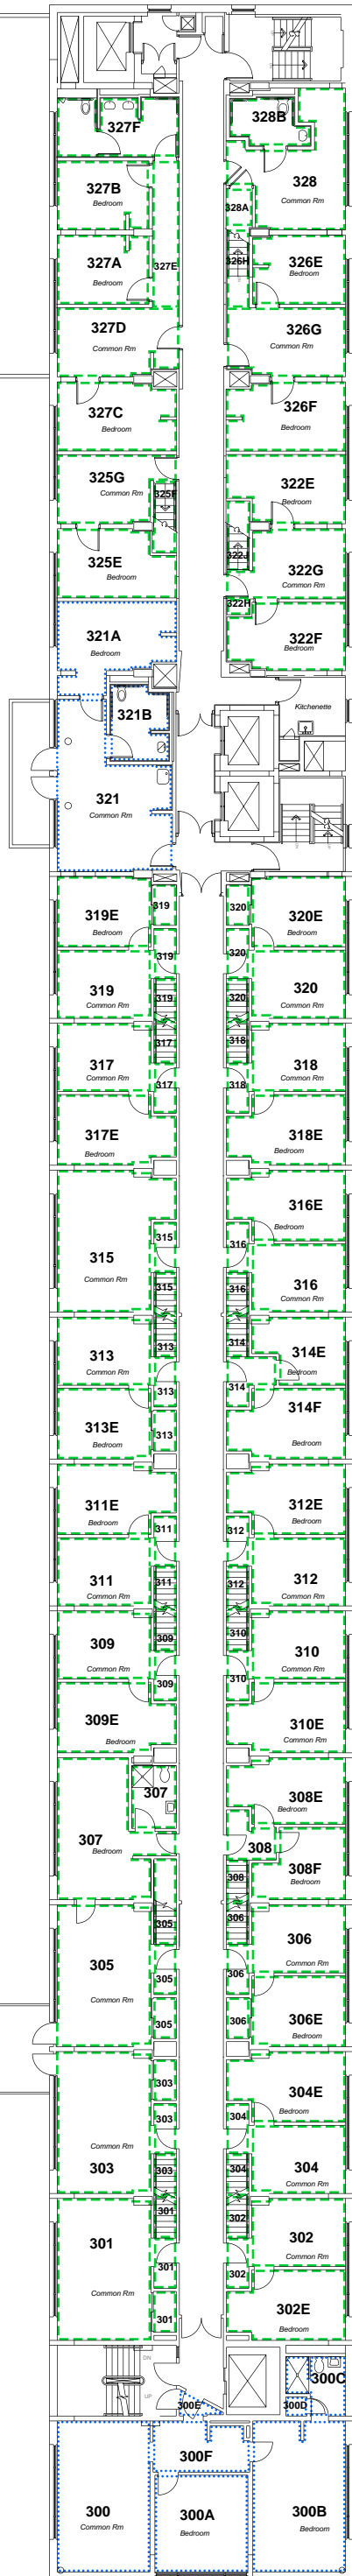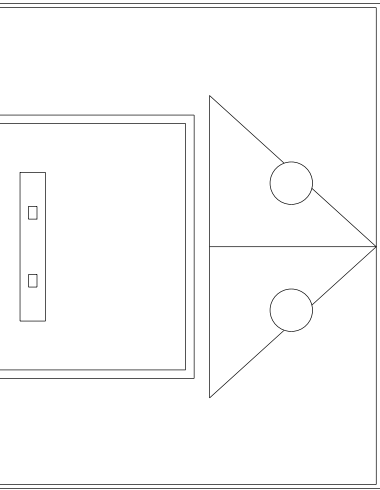

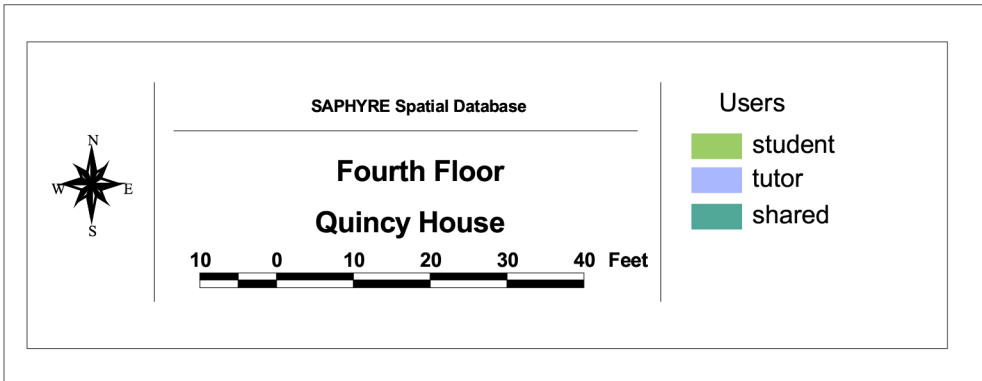

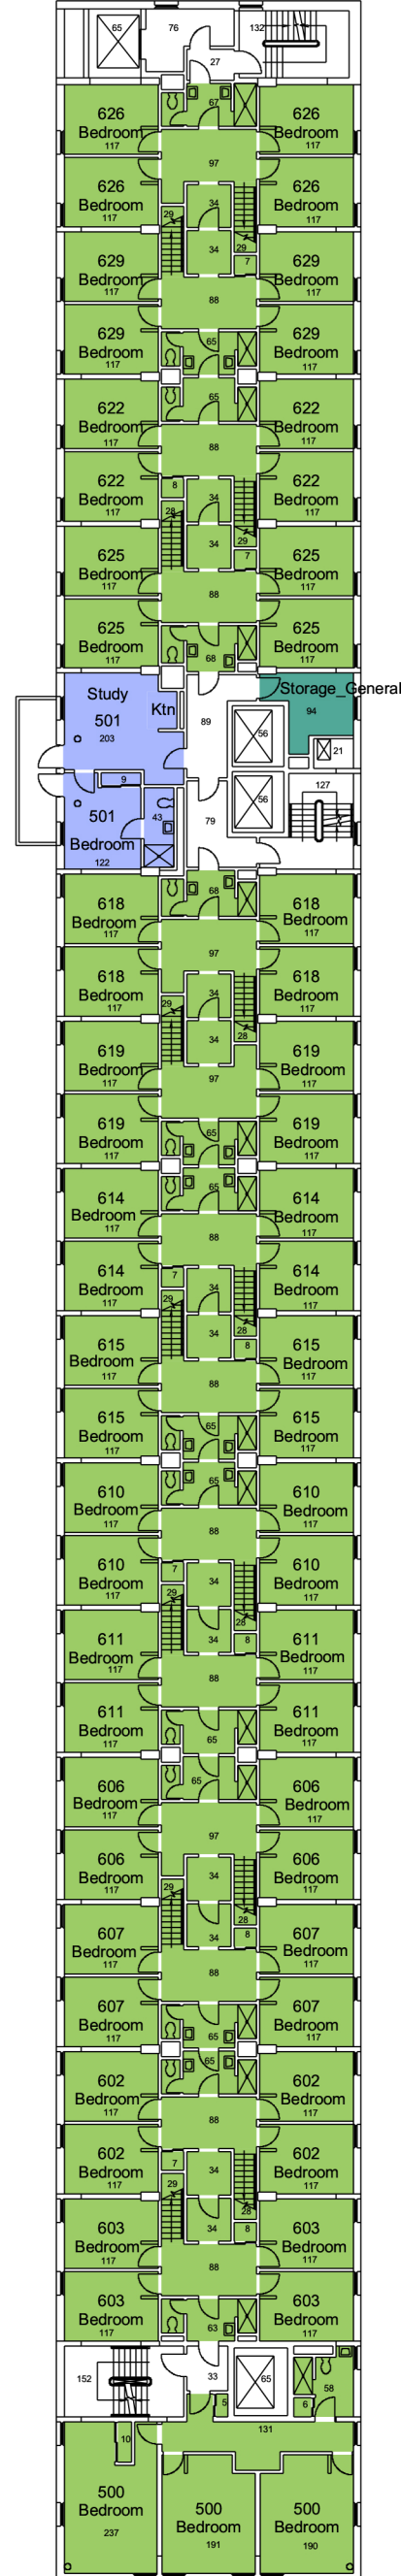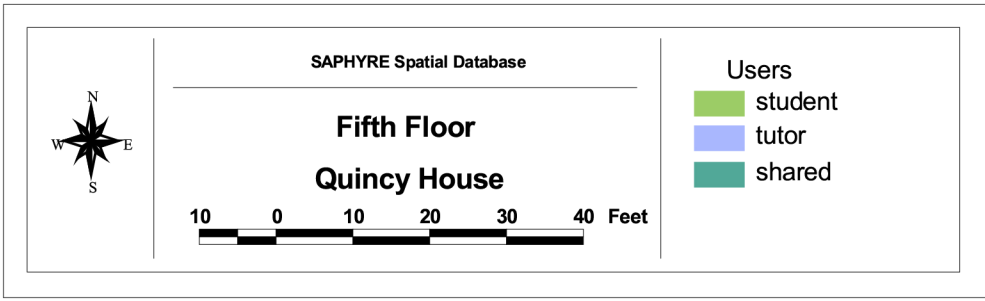

### Sixth Floor Quincy House




#### Users

- student
- tutor
- shared




### Seventh Floor

### Quincy House

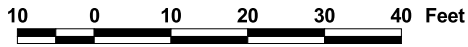

- Users
- masters aides
  - student
  - tutor

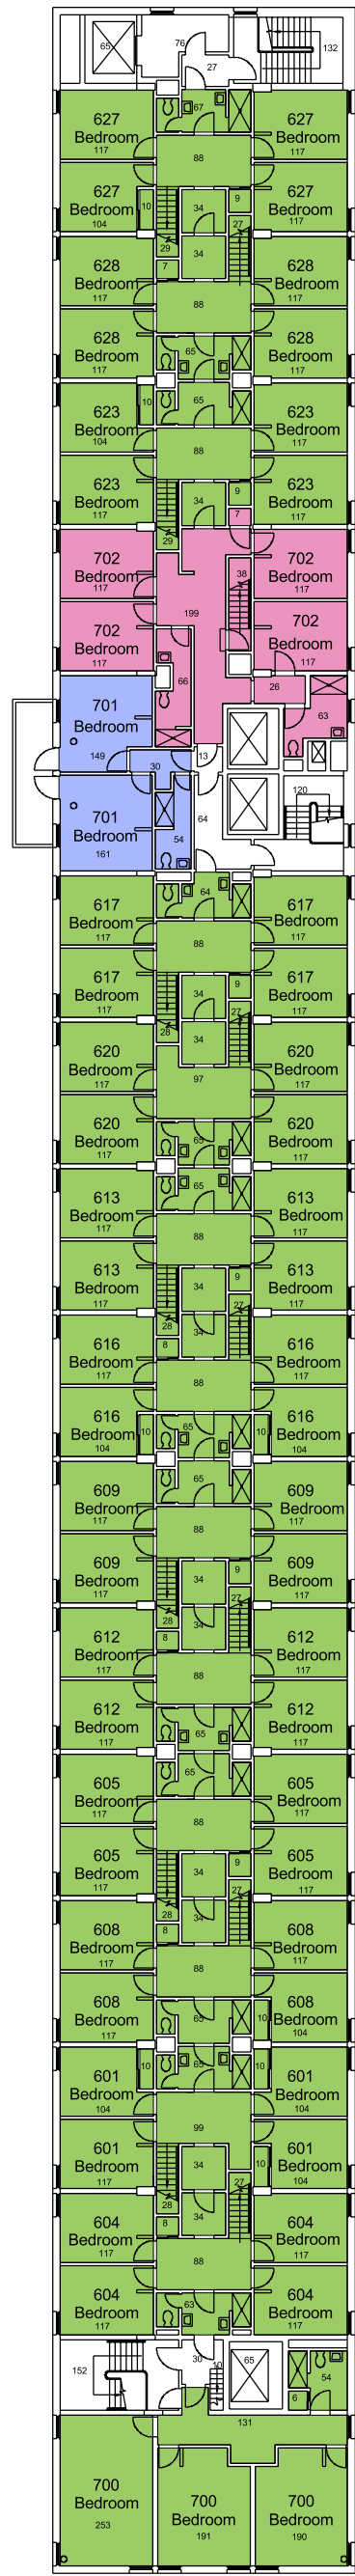

### Eighth Floor


### Quincy House

10 0 10 20 30 40 50 Feet




#### Users

masters

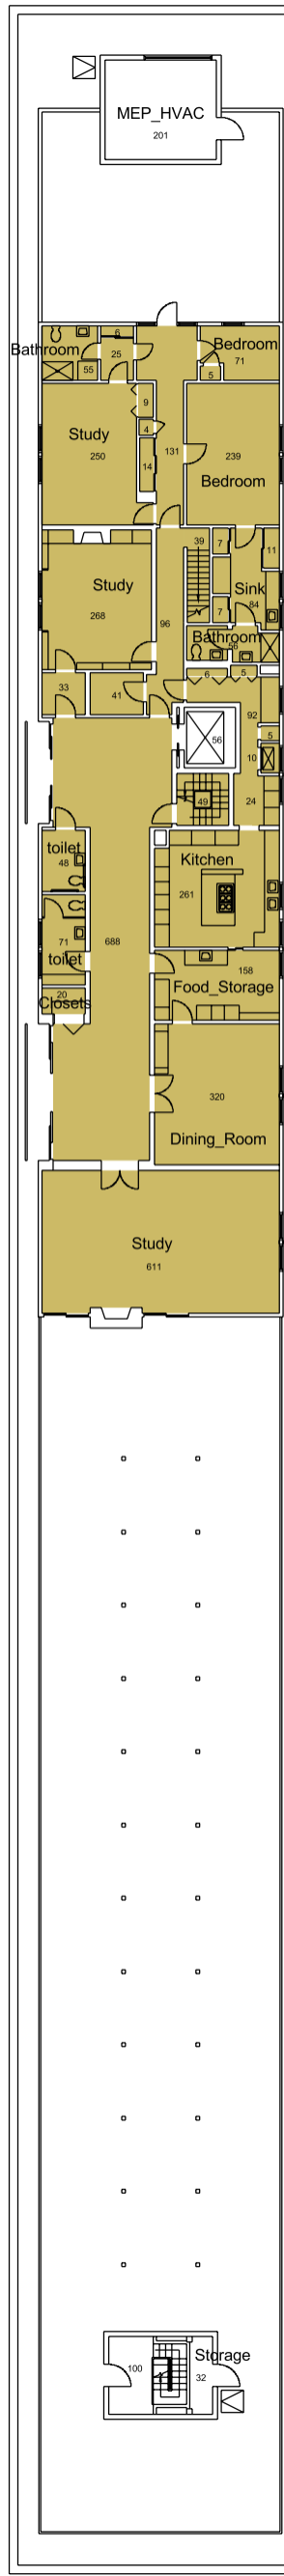




**Ninth Floor**  
**Quincy House**

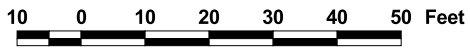

Users

 masters

